

REVISION	NO.	DATE	DESCRIPTION	BY
1	06-18-09		PLAN CHECK CORRECTIONS	JKW

EXTERIOR ELEVATIONS

ROBERT HURLE
5040 HAMPDEN COURT
GRANITE BAY, CA 95746
(916) 783-9042

WTTTELS ENGINEERING

POST OFFICE BOX 1017, TAHOE CITY, CA 96145
TELEPHONE (530) 583-2430
FACSIMILE (530) 583-2435



710 TAHOE STREET
TAHOE CITY, CALIFORNIA


HURLE RESIDENCE
1200 EDELWEISS LANE
LOT 124, TAHOE CITY
A.P.N. 083-281-005

PLACER COUNTY
CALIFORNIA

SCALE: 3/8" = 1'-0"
PLOT DATE: MAY 29, 2009
DRAWING: 32525C
PROJECT #: 3252.00
DISK #: JKW
SHEET

A3.1

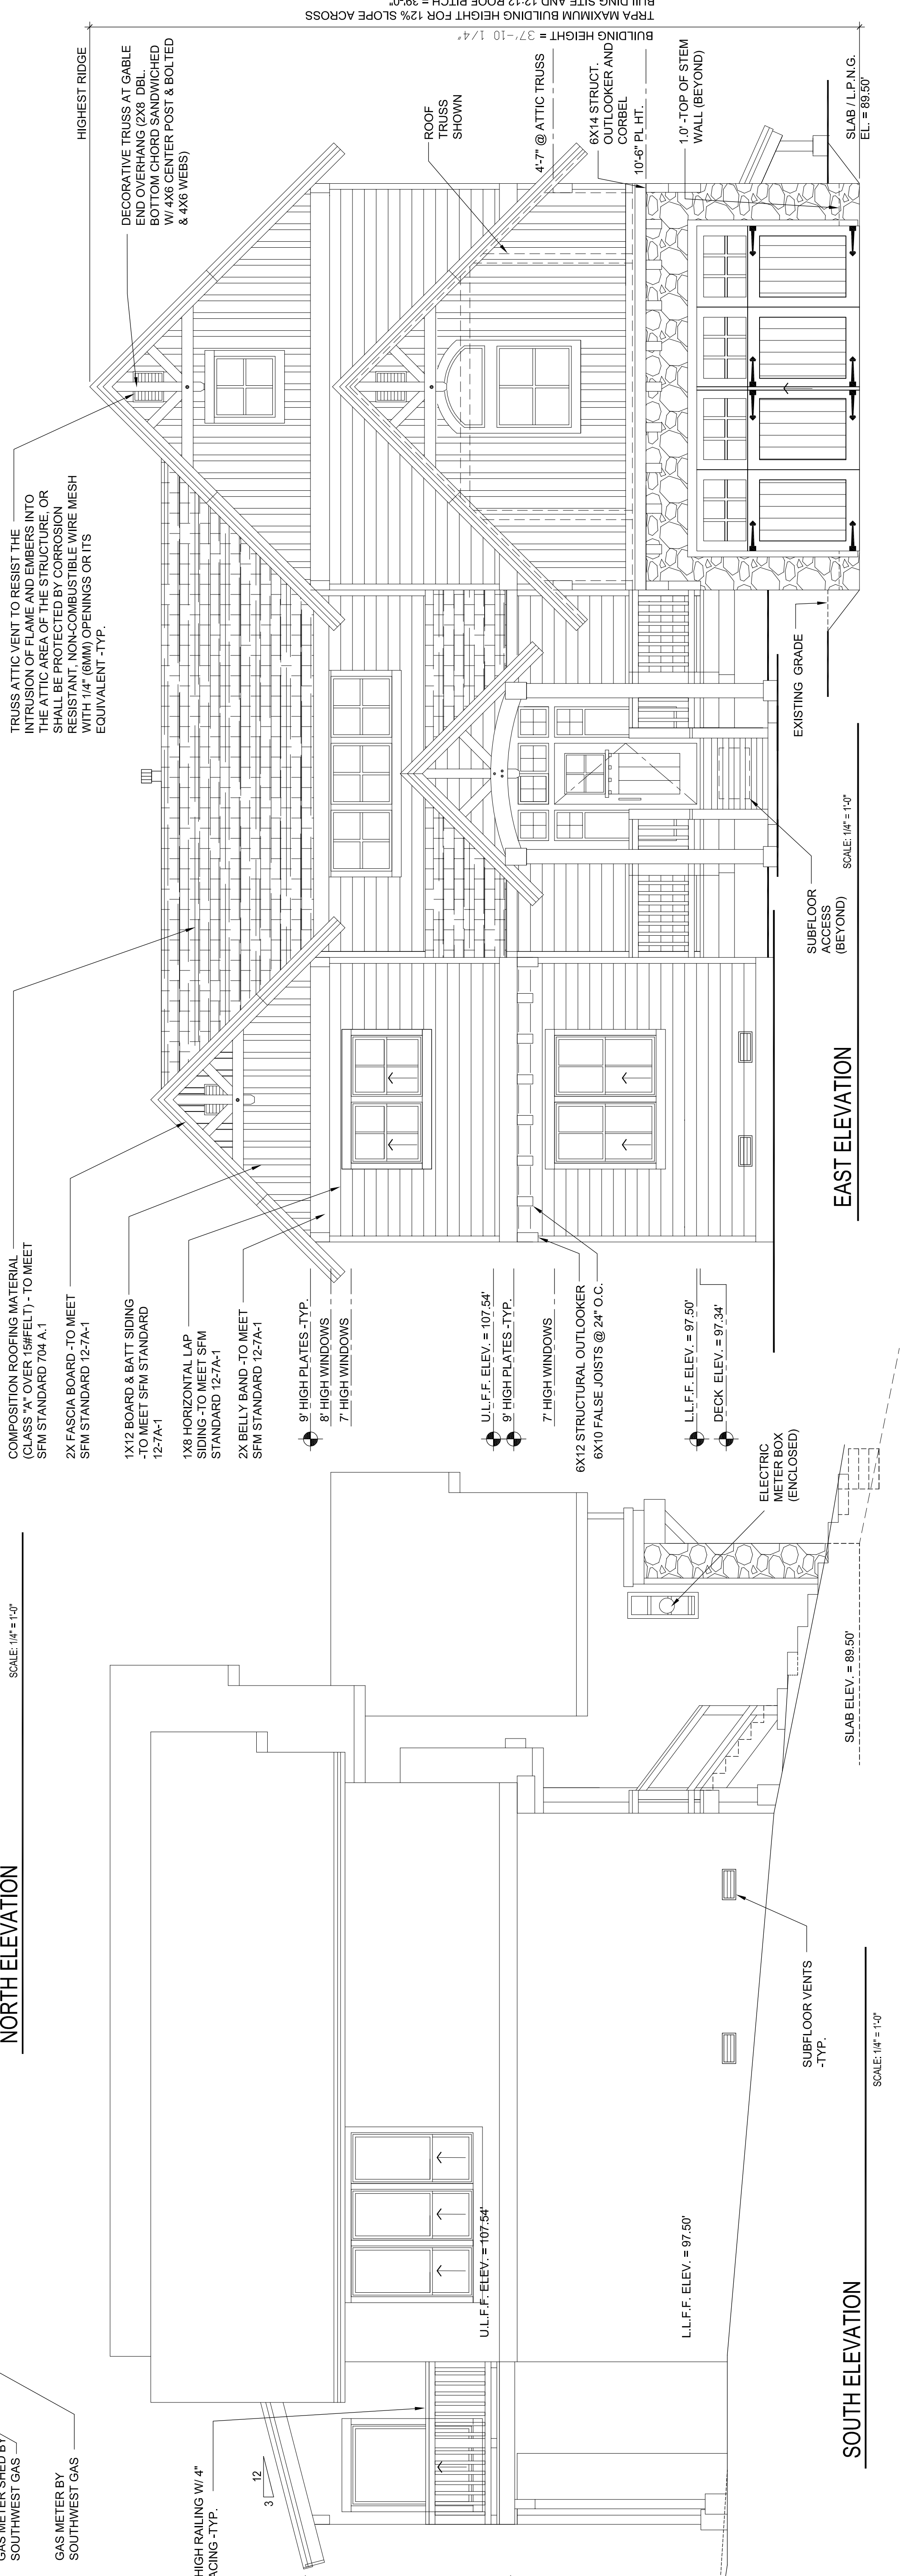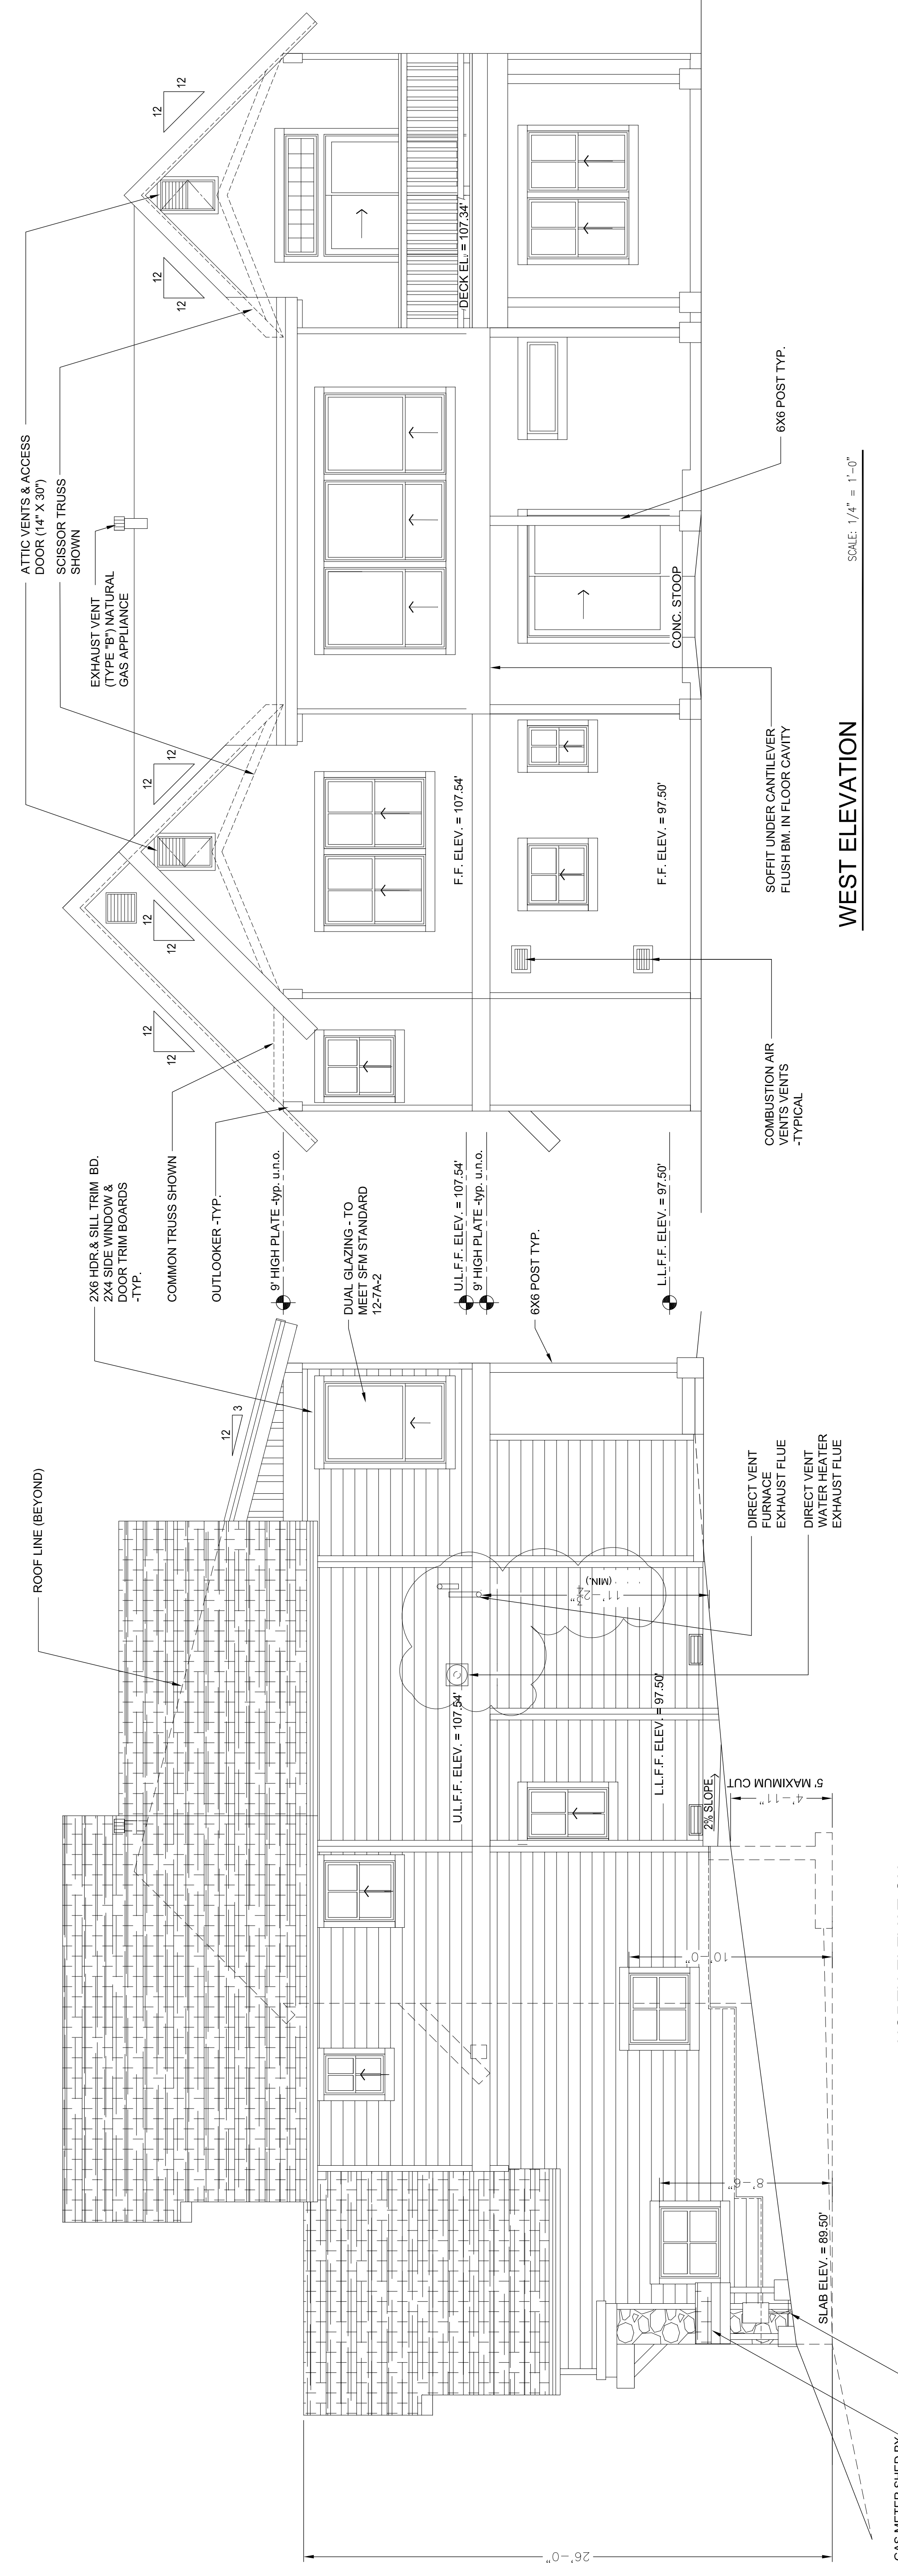

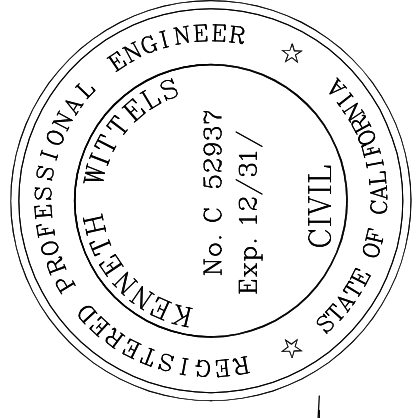


FLOOR AREAS

LOWER
 GARAGE FLOOR AREA = 490 S.F.
 CONDITIONED FLOOR AREA = 1,072 S.F.


UPPER
 CONDITIONED FLOOR AREA = 1,341 S.F.

TOTAL CONDITIONED FLOOR AREA = 2,413 S.F.
 GRAND TOTAL FLOOR AREA = 2,903 S.F.

LOWER LEVEL FLOOR PLAN
 SCALE: 1/4"=1'-0"

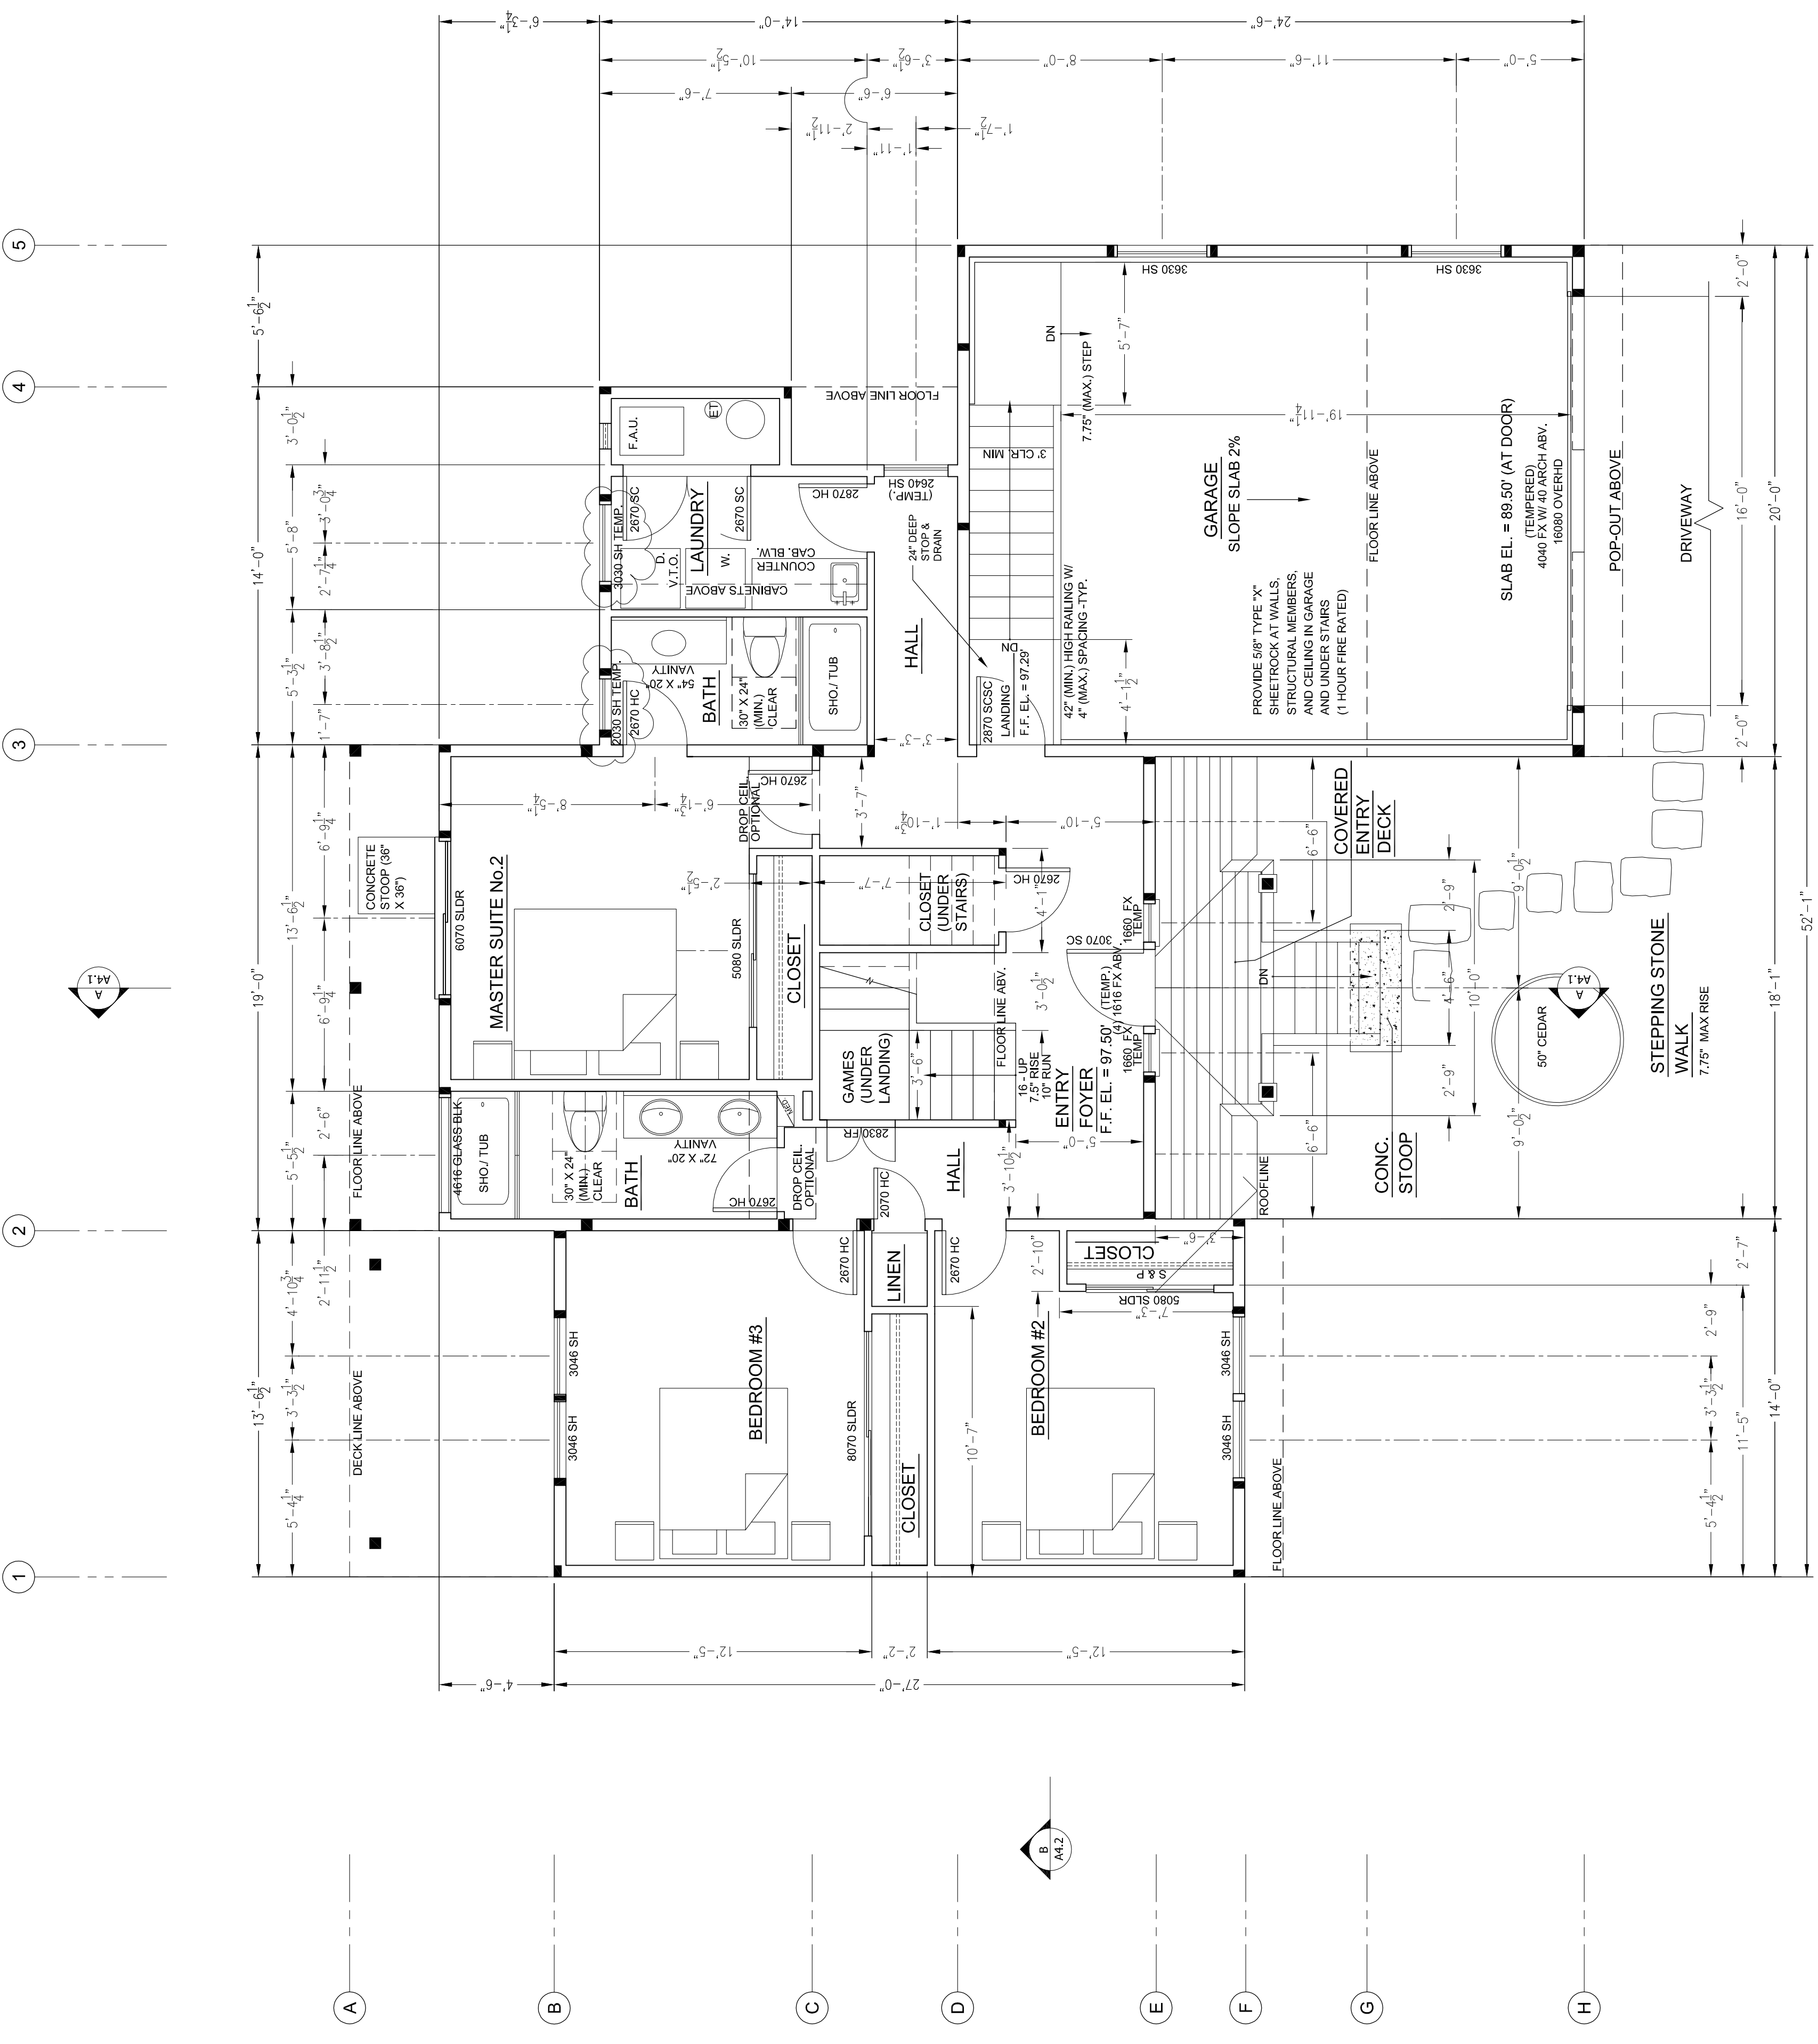

WITTELS ENGINEERING POST OFFICE BOX 1017, TAHOE CITY, CA 96145 TELEPHONE (530) 583-2435 FACSIMILE (530) 583-1130	710 TAHOE STREET TAHOE CITY, CALIFORNIA CALIFORNIA	HURLE RESIDENCE 1200 EDELWEISS LANE LOT 124, TAHOE CITY A.P.N. 083-281-005 PLACER COUNTY CALIFORNIA	SCALE: 1/4" = 1'-0" PLOT DATE: MAY 29, 2009 DRAWING: 3252FP PROJECT #: 3252.00 DRAWN BY: JKW/JDC SHEET	A2.1
LOWER LEVEL FLOOR PLAN ROBERT HURLE 5040 HAMPTON COURT GRANITE BAY, CA 95746 (916) 783-9042	REVISION NO. DATE DESCRIPTION BY	1 06-18-09 PLAN CHECK CORRECTIONS JKW		

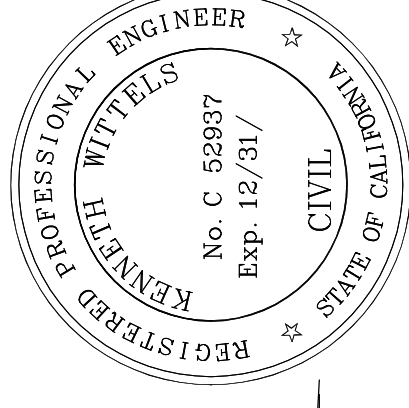

A2.2

SHEET

DRAWN BY: JKW/JDC

PROJECT #: 3252.00

DRAWING: 3252FP

PLOT DATE: MAY 29, 2009


SCALE: 1/4" = 1'-0"

HURLE RESIDENCE
1200 EDELWEISS LANE
LOT 124, TAHOE CITY
A.P.N. 083-281-005
PLACER COUNTY
CALIFORNIA

WITTELS ENGINEERING
POST OFFICE BOX 1017, TAHOE CITY, CA 96145
710 TAHOE STREET
TAHOE CITY, CALIFORNIA
TELEPHONE (530) 583-1190
FACSIMILE (530) 583-2485

MAIN LEVEL FLOOR PLAN
ROBERT HURLE
5040 HAMPTON COURT
GRANITE BAY, CA 95746
(916) 783-9042

REVISION	NO.	DATE	DESCRIPTION	BY

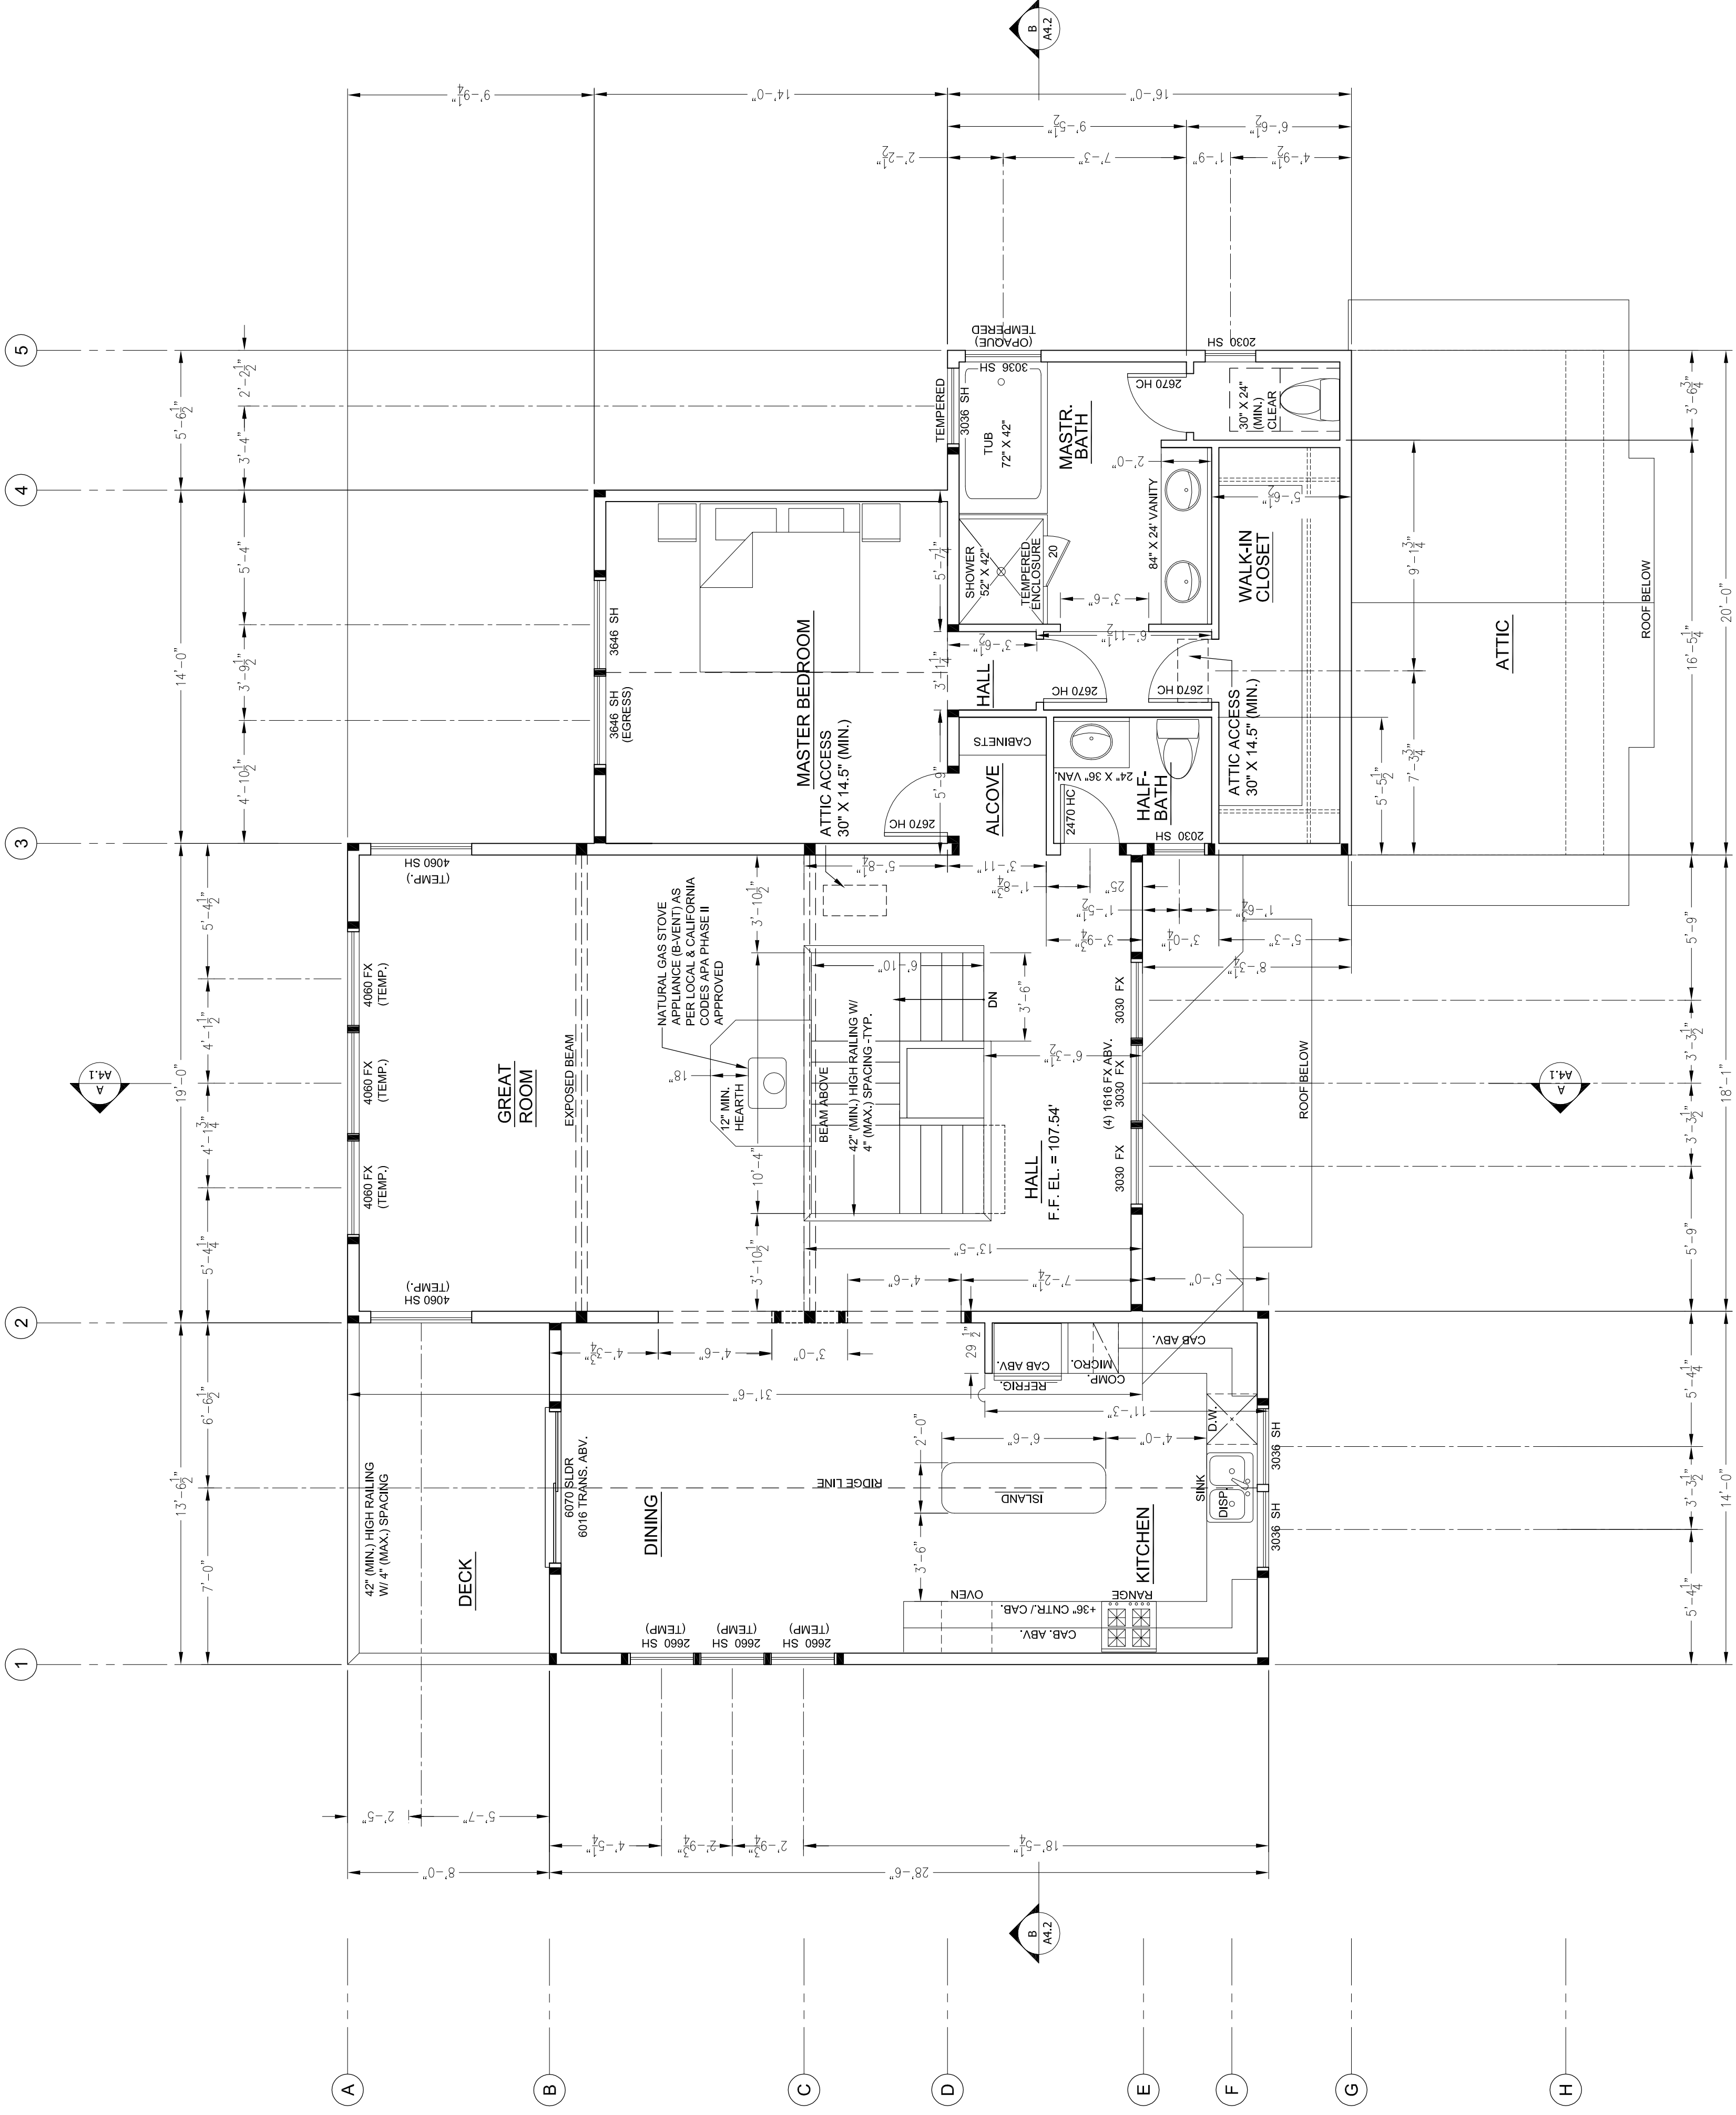

UPPER LEVEL FLOOR PLAN

SCALE: 1/4"=1'-0"